


THE ROOM AS BUILT

PLAN · SCALE 1:40 · SHELL ONLY, NO FURNITURE · CEILING 2789 (9 FT 1 IN) LEVEL THROUGHOUT

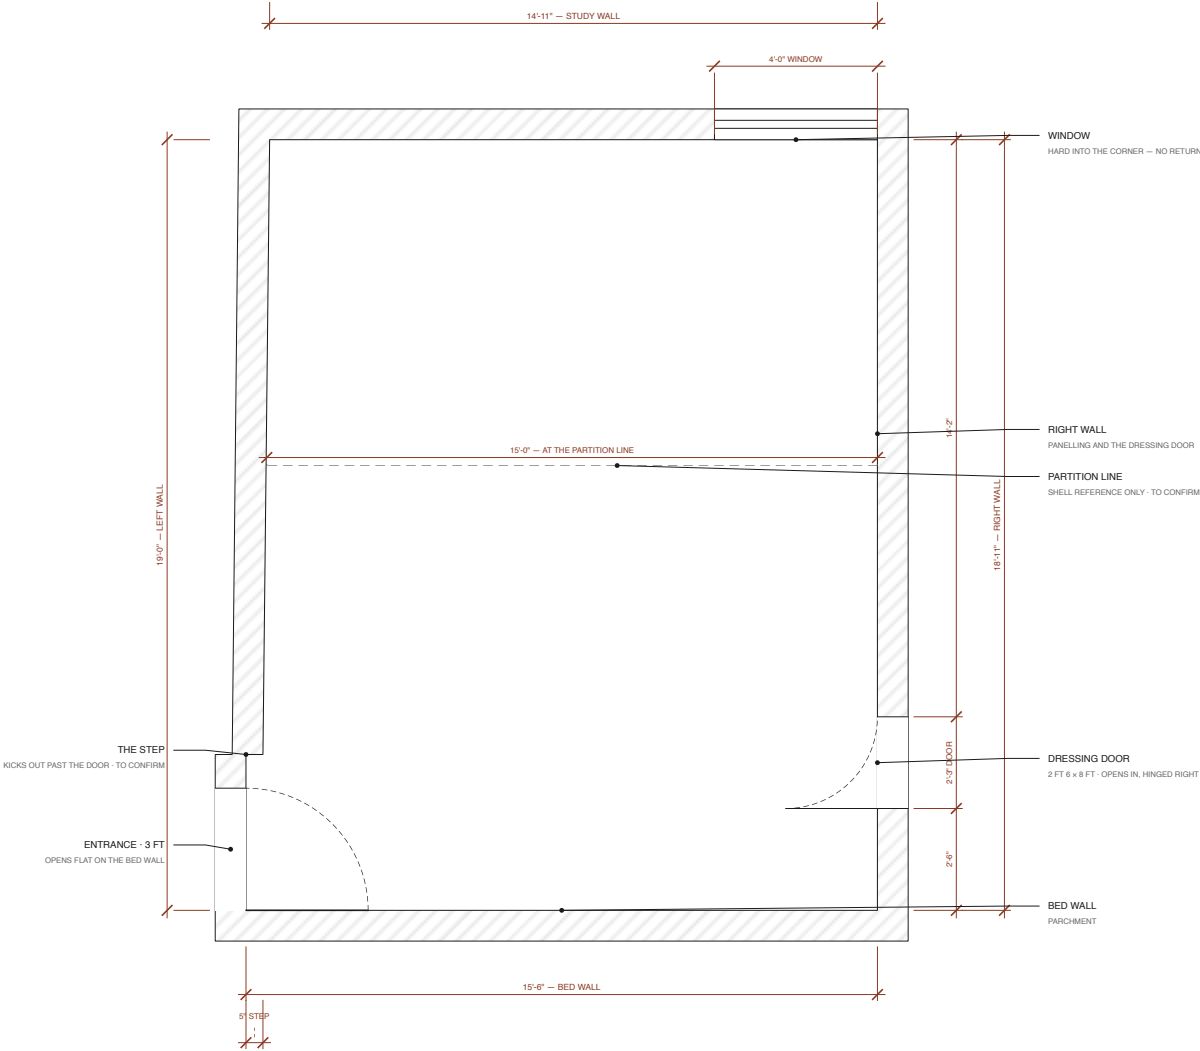

NOTES

REVISION 6

The room is not square. It widens about 2 in from the

study wall to the bed wall — roughly half a degree.

Diagonals measured 24 ft 5 in and 23 ft 11 in.

Right wall — 13 ft 6 in to the door frame and 18 ft 11 in

overall are drawn exactly; the 3 ft frame and 2 ft 4 in

return do not both fit with a 2 in lining. See AST-DR-007.

The right wall is taken as the straight reference; the left

wall carries the splay and the step.

Ceiling 9 ft 1 in, level throughout. The main room ceiling

is plain, so the splay never shows from above.

Floor, marble border and skirting are laid. Skirting runs

on three walls only: bed, left and right.

Every fitted piece to be built 15–20 undersize and scribed

on site to the wall it actually meets.

Furniture, partition and joinery are NOT shown.

Bathroom and dressing lie beyond the right wall — to come.

A STUDY IN TEAK

Particulars of the room

THE ROOM AS BUILT

Shell plan · measured on site

SCALE
1:40 @ A3

DATE
19.09.2026

REV
6 — the partition line at 11 ft from the bed wall, 8 ft from the study wall

DWG
AST-DR-000