

PLAN - SHELL ONLY, NO FURNITURE - CEILING 9'-1" LEVEL THROUGHOUT




REVISION 6

A STUDY IN TEAK Particulars of the room	
THE ROOM AS BUILT Shell plan - measured on site	
SCALE 1:40 @ A3	DATE 19.09.2025
REV 4 - the partition line at 11 ft from the bed wall, 8 ft from the study wall	DWG AST-DR-000

DRAWING
AST-DR-000 · 1 of 3

THE ROOM AS BUILT

SCALE 1:60 @ A4 · PLAN · SHELL ONLY, NO FURNITURE · CEILING 9'-1" LEVEL THROUGHOUT

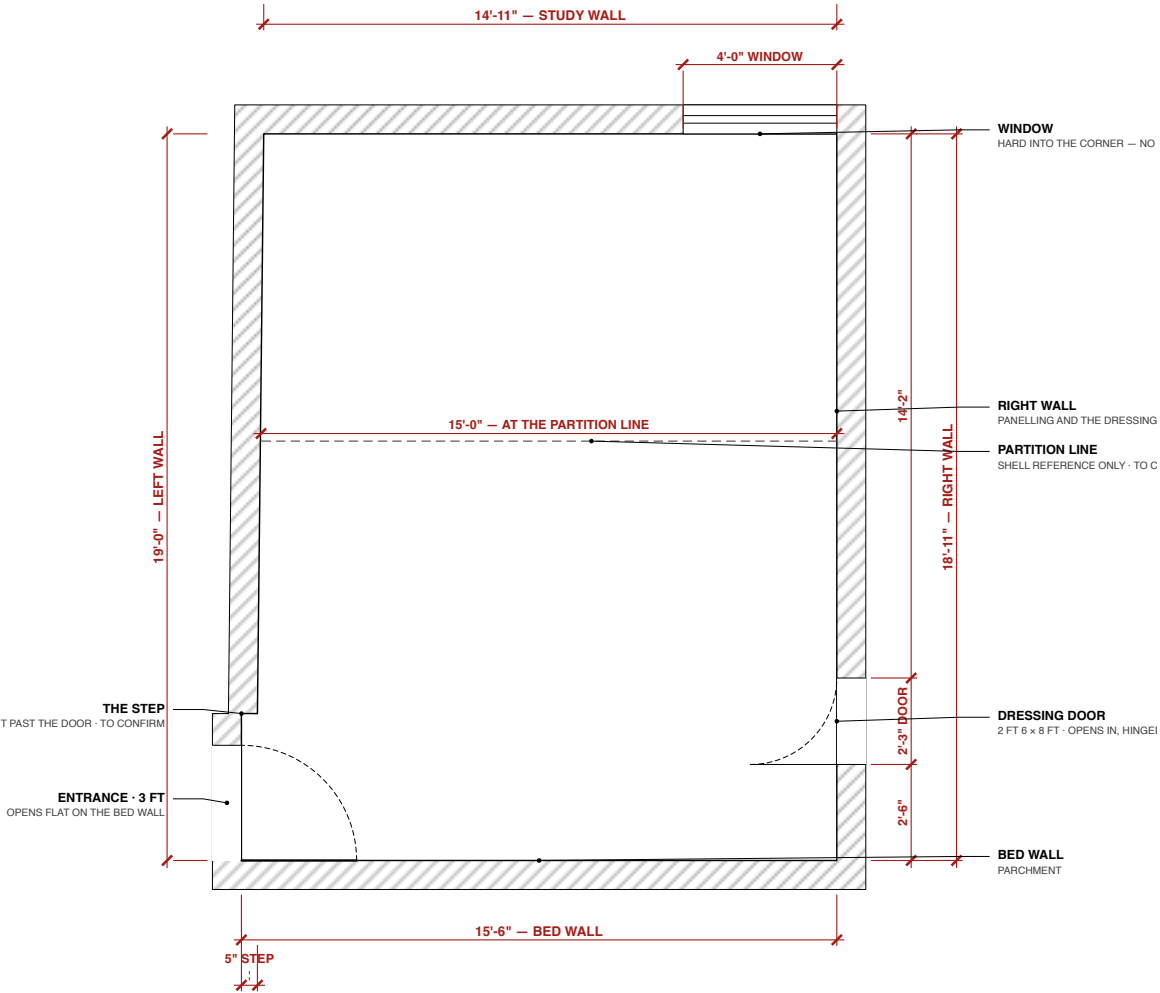

PROJECT
A Study in Teak — The Room As Built

SHEET
The room as built
Shell plan · measured on site

SCALE
1:60 @ A4

DATE
19.09.2026

REV
6

DRAWING
AST-DR-000 · 2 of 3

NOTES

REVISION 6

The room is not square. It widens about 2 in from the study wall to the bed wall — roughly half a degree.

Diagonals measured 24 ft 5 in and 23 ft 11 in.

Right wall — 13 ft 6 in to the door frame and 18 ft 11 in overall are drawn exactly; the 3 ft frame and 2 ft 4 in return do not both fit with a 2 in lining. See AST-DR-007.

The right wall is taken as the straight reference; the left wall carries the splay and the step.

Ceiling 9 ft 1 in, level throughout. The main room ceiling is plain, so the splay never shows from above.

Floor, marble border and skirting are laid. Skirting runs on three walls only: bed, left and right.

Every fitted piece to be built $\frac{5}{8}$ "– $\frac{3}{4}$ " undersize and scribed on site to the wall it actually meets.

Furniture, partition and joinery are NOT shown.

Bathroom and dressing lie beyond the right wall — to come.

PROJECT	SHEET	SCALE	DATE	REV	DRAWING
A Study in Teak — The Room As Built	Notes Shell plan · measured on site	NTS	19.09.2026	6	AST-DR-000 · 3 of 3