


THE ROOM AS BUILT

PLAN · SHELL ONLY, NO FURNITURE · CEILING 9'-1" LEVEL THROUGHOUT

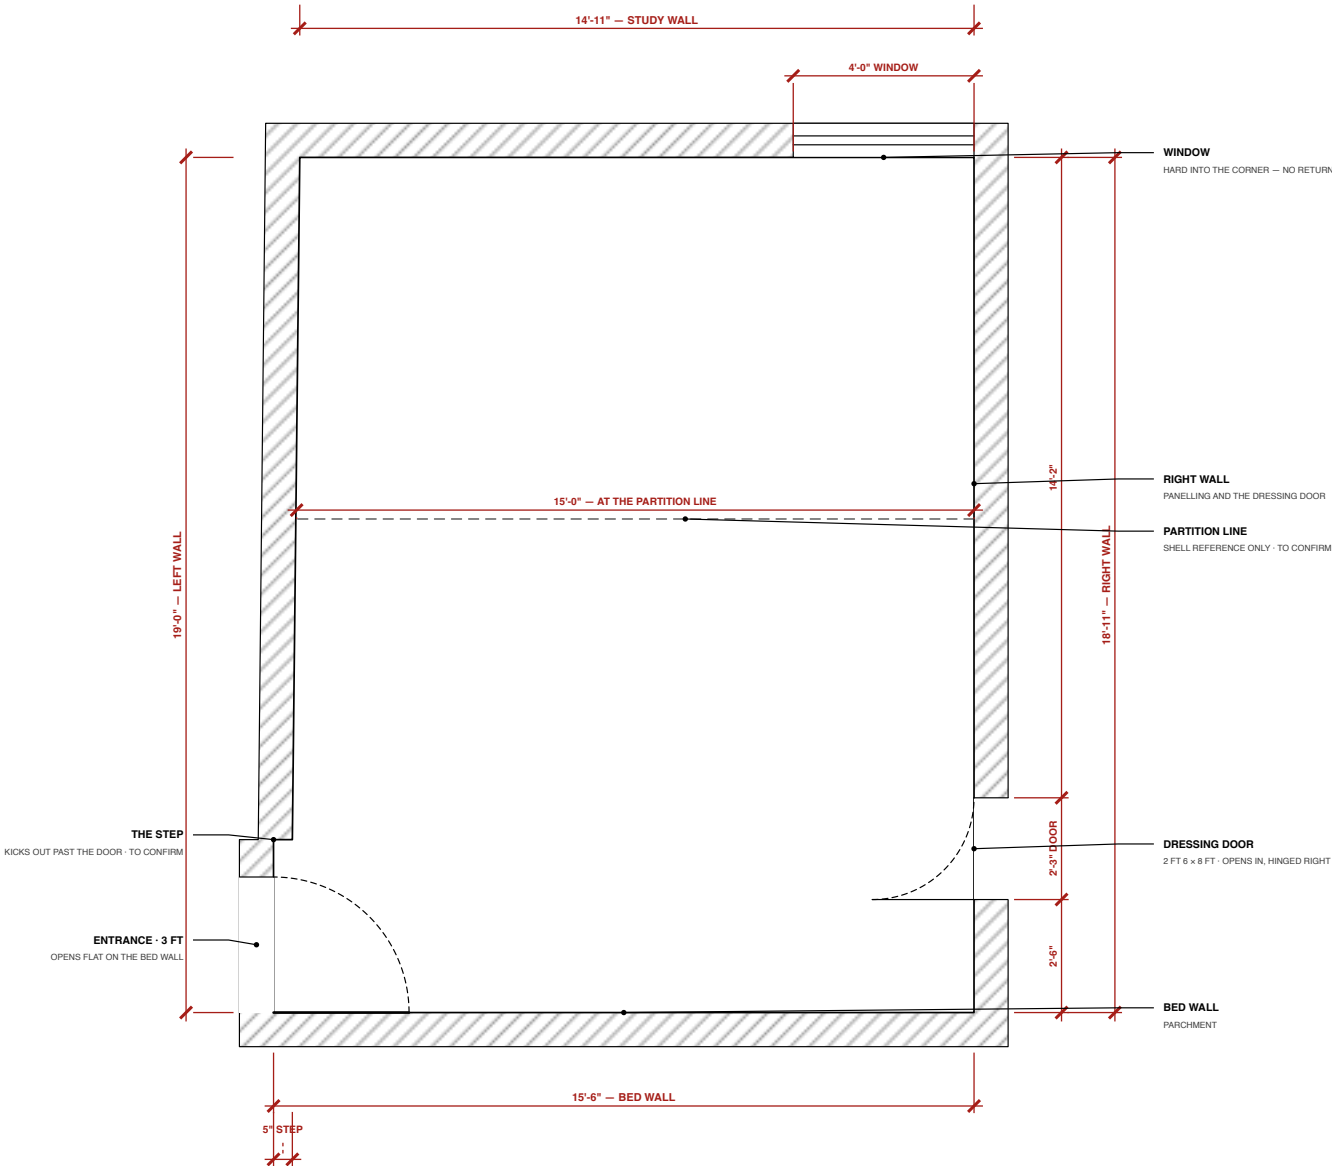

NOTES

REVISION 6

The room is not square. It widens about 2 in from the study wall to the bed wall — roughly half a degree.

Diagonals measured 24 ft 5 in and 23 ft 11 in.

Right wall — 13 ft 6 in to the door frame and 18 ft 11 in

overall are drawn exactly; the 3 ft frame and 2 ft 4 in return do not both fit with a 2 in lining. See AST-DR-007.

The right wall is taken as the straight reference; the left wall carries the splay and the step.

Ceiling 9 ft 1 in, level throughout. The main room ceiling is plain, so the splay never shows from above.

Floor, marble border and skirting are laid. Skirting runs on three walls only: bed, left and right.

Every fitted piece to be built 5/16"-3/4" undersize and scribed on site to the wall it actually meets.

Furniture, partition and joinery are NOT shown.

Bathroom and dressing lie beyond the right wall — to come.

A STUDY IN TEAK

Particulars of the room

THE ROOM AS BUILT

Shell plan · measured on site

SCALE

1:40 @ A3

DATE

19.09.2026

REV

6 — the partition line at 11 ft from the bed wall, 8 ft from the study wall

DWG

AST-DR-000

PROJECT

A Study in Teak — The Room As Built

SHEET

General arrangement — the whole sheet

each view follows at its own scale, pages 2 to 3

SCALE

NTS

DATE

19.09.2026

REV



6

DRAWING

AST-DR-000 · 1 of 3

THE ROOM AS BUILT

SCALE 1:40 @ A3 · PLAN · SHELL ONLY, NO FURNITURE · CEILING 9'-1" LEVEL THROUGHOUT

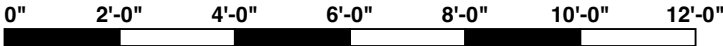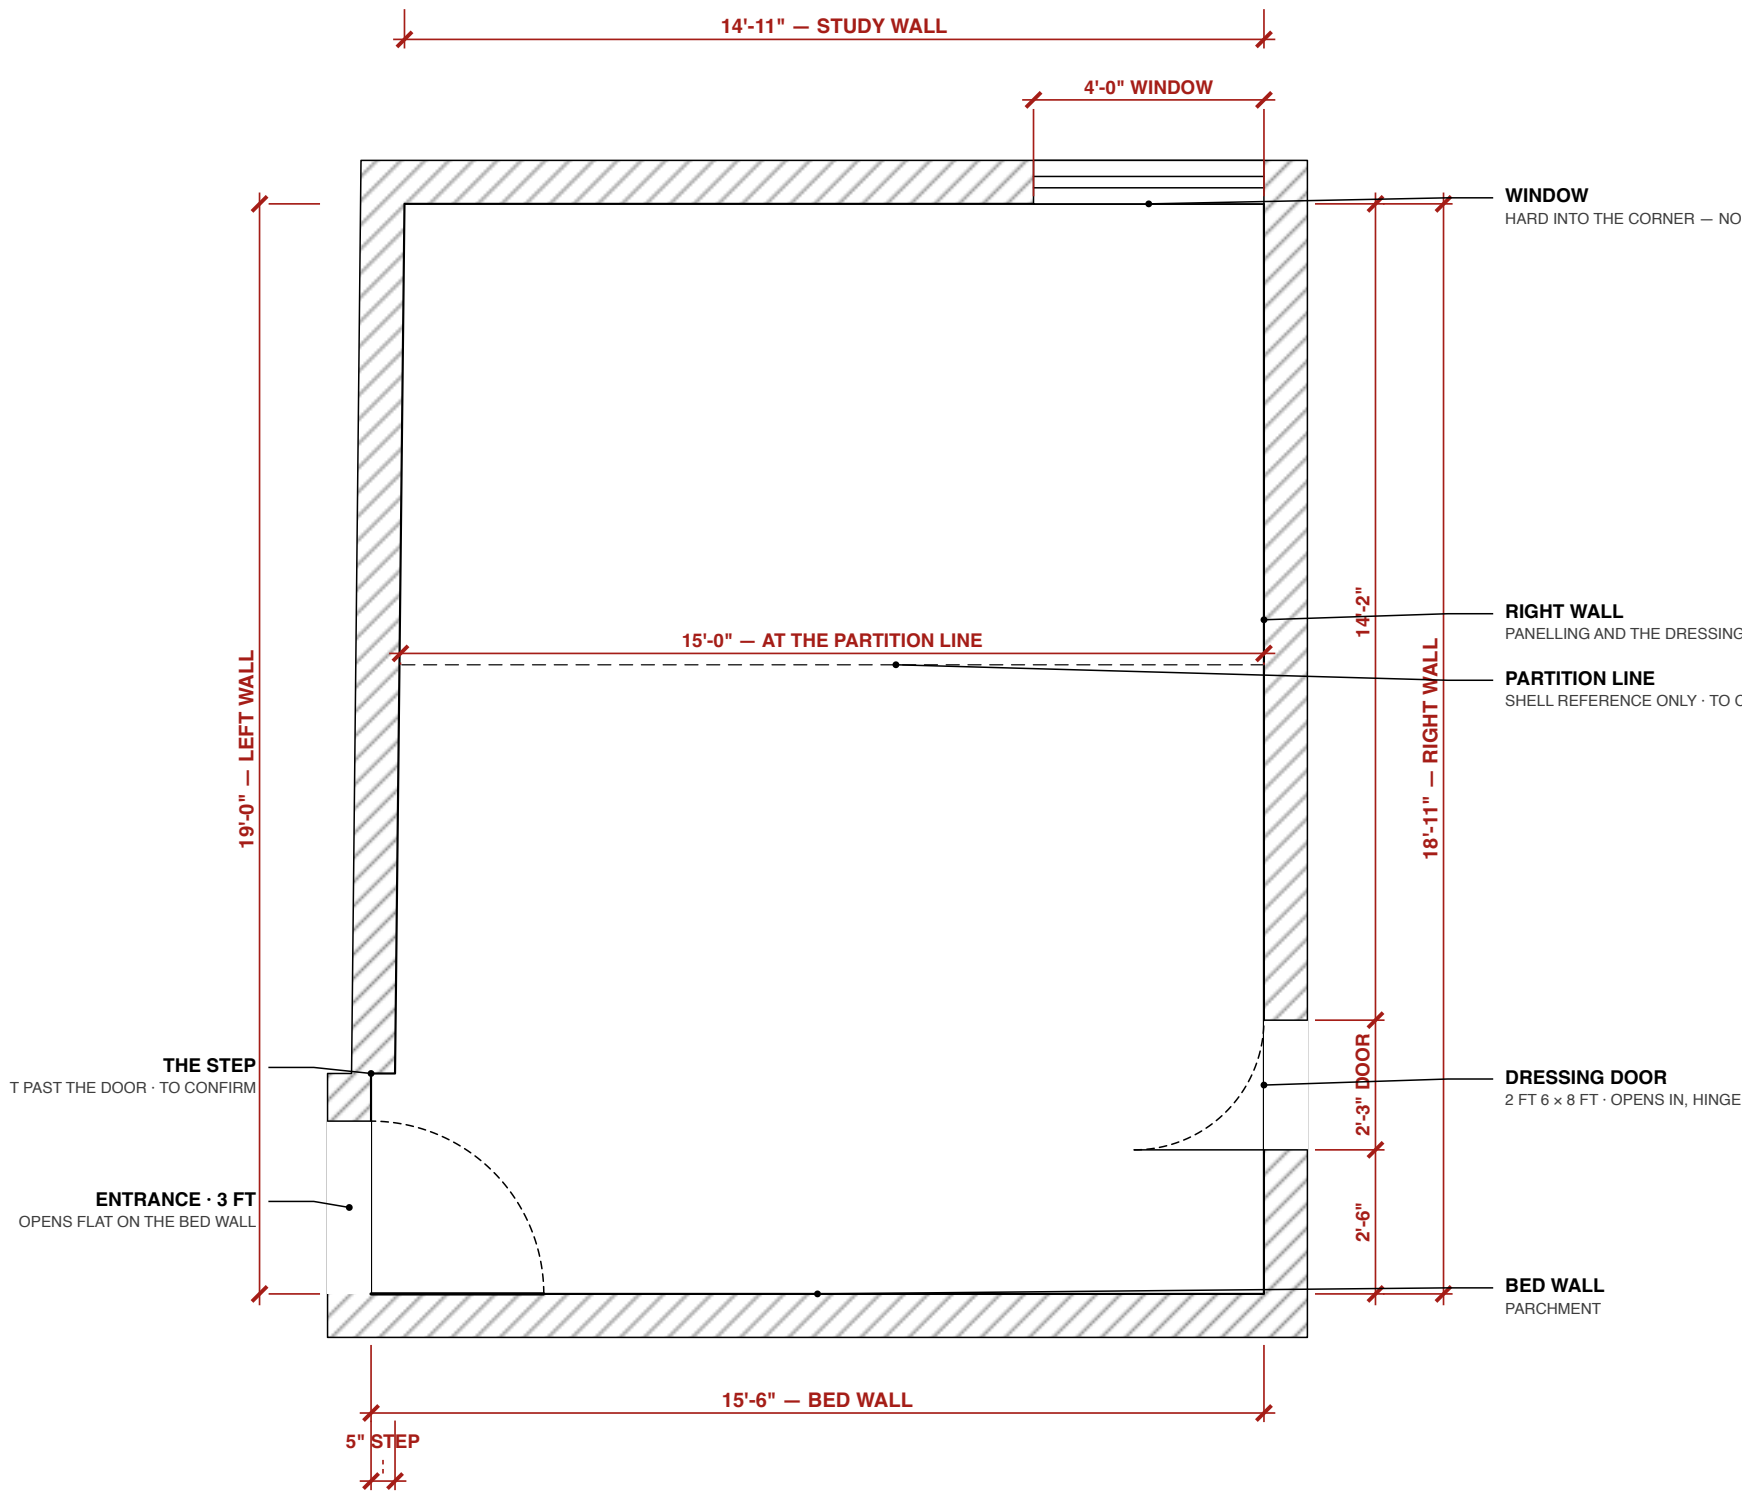

PROJECT
A Study in Teak — The Room As Built

SHEET
The room as built
Shell plan · measured on site

SCALE
1:40 @ A3

DATE
19.09.2026

REV
6

DRAWING
AST-DR-000 · 2 of 3

NOTES

REVISION 6

The room is not square. It widens about 2 in from the study wall to the bed wall — roughly half a degree.

Diagonals measured 24 ft 5 in and 23 ft 11 in.

Right wall — 13 ft 6 in to the door frame and 18 ft 11 in overall are drawn exactly; the 3 ft frame and 2 ft 4 in return do not both fit with a 2 in lining. See AST-DR-007.

The right wall is taken as the straight reference; the left wall carries the splay and the step.

Ceiling 9 ft 1 in, level throughout. The main room ceiling is plain, so the splay never shows from above.

Floor, marble border and skirting are laid. Skirting runs on three walls only: bed, left and right.

Every fitted piece to be built 5⁄8"–3⁄4" undersize and scribed on site to the wall it actually meets.

Furniture, partition and joinery are NOT shown.

Bathroom and dressing lie beyond the right wall — to come.

PROJECT
A Study in Teak — The Room As Built

SHEET
Notes
Shell plan · measured on site

SCALE
NTS

DATE
19.09.2026

REV
6

DRAWING
AST-DR-000 · 3 of 3