
THE ROOM AS BUILT

PLAN · SHELL ONLY, NO FURNITURE · CEILING 9'-1" LEVEL THROUGHOUT

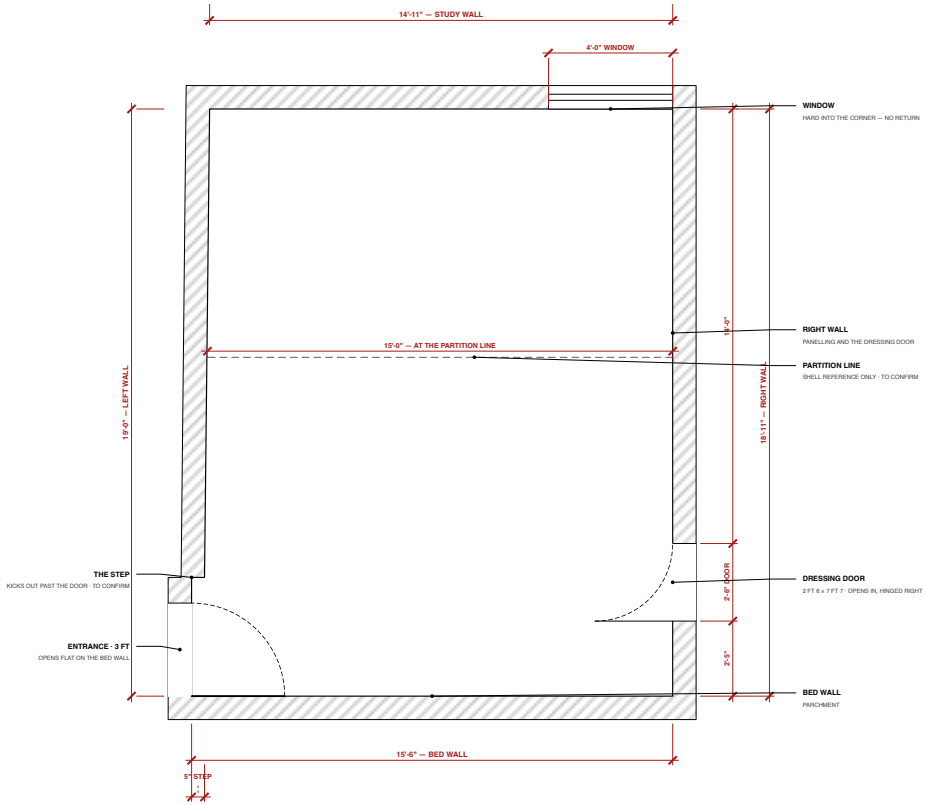

NOTES

REVISION 7

The room is not square. It widens about 2 in from the study wall to the bed wall — roughly half a degree.

Diagonals measured 24 ft 5 in and 23 ft 11 in.

Right wall — 18 ft 11 in overall; the dressing door is a 2 ft 6 leaf in a 2 in frame with 2 ft 3 in of wall to the corner (1¼" Sept). That puts the frame 13 ft 10 from the study corner, 4 in off the 13 ft 6 taped on ¾" Sept. See AST-DR-007.

The right wall is taken as the straight reference; the left wall carries the splay and the step.

Ceiling 9 ft 1 in, level throughout. The main room ceiling is plain, so the splay never shows from above.

Floor, marble border and skirting are laid. Skirting runs on three walls only: bed, left and right.

Every fitted piece to be built ⅛"–¼" undersize and scribed on site to the wall it actually meets.

Furniture, partition and joinery are NOT shown.

Bathroom and dressing lie beyond the right wall — to come.

A STUDY IN TEAK

Particulars of the room

THE ROOM AS BUILT

Shell plan · measured on site


SCALE	DATE
1:40 @ A3	16.10.2026
REV	DWG
7 — the dressing door at the owner's 27 Sept tape (2 ft 6 in leaf, 2 ft 3 in of wall to the corner)	AST-DR-000


PROJECT	SHEET	SCALE	DATE	REV	DRAWING
A Study in Teak — The Room As Built	**General arrangement — the whole sheet** each view follows at its own scale, pages 2 to 3	NTS	16.10.2026	7	**AST-DR-000 · 1 of 3**

ALL DIMENSIONS IN FEET & INCHES. PRINT ON A4 AT 100% / "ACTUAL SIZE" — NOT "FIT TO PAGE" — AND CHECK THE SCALE BAR. DO NOT SCALE; WORK TO FIGURED DIMENSIONS. VERIFY ON SITE.

THE ROOM AS BUILT

SCALE 1:60 @ A4 · PLAN · SHELL ONLY, NO FURNITURE · CEILING 9'-1" LEVEL THROUGHOUT

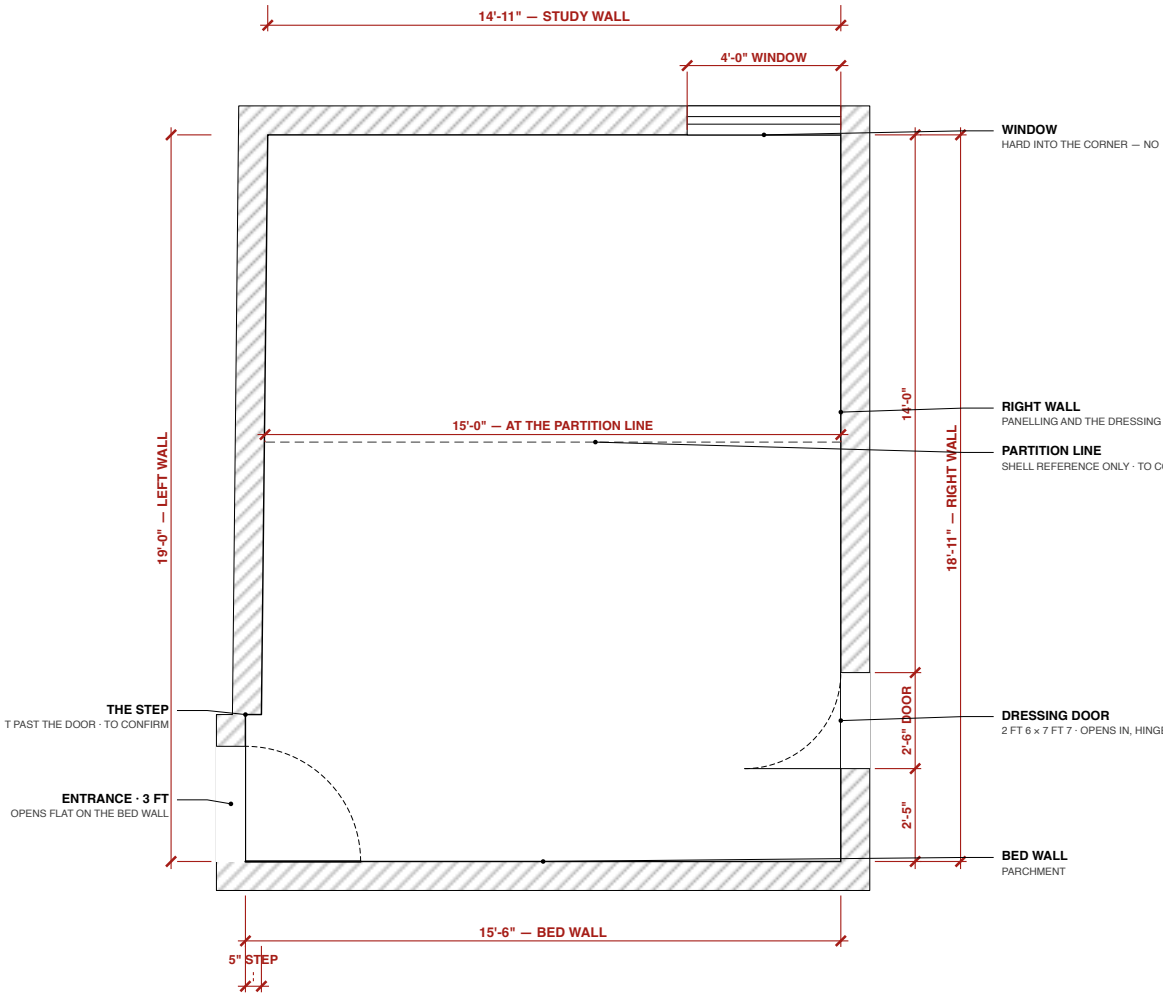

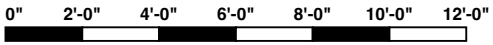

PROJECT	SHEET	SCALE	DATE	REV	DRAWING
A Study in Teak — The Room As Built	**The room as built** Shell plan · measured on site	1:60 @ A4	16.10.2026	7	**AST-DR-000 · 2 of 3**

ALL DIMENSIONS IN FEET & INCHES. PRINT ON A4 AT 100% / "ACTUAL SIZE" — NOT "FIT TO PAGE" — AND CHECK THE SCALE BAR. DO NOT SCALE; WORK TO FIGURED DIMENSIONS. VERIFY ON SITE.

NOTES

REVISION 7

The room is not square. It widens about 2 in from the

study wall to the bed wall — roughly half a degree.

Diagonals measured 24 ft 5 in and 23 ft 11 in.

Right wall — 18 ft 11 in overall; the dressing door is a 2 ft 6

leaf in a 2 in frame with 2 ft 3 in of wall to the corner

(1⅛" Sept). That puts the frame 13 ft 10 from the study

corner, 4 in off the 13 ft 6 taped on ¾" Sept. See AST-DR-007.

The right wall is taken as the straight reference; the left

wall carries the splay and the step.

Ceiling 9 ft 1 in, level throughout. The main room ceiling

is plain, so the splay never shows from above.

Floor, marble border and skirting are laid. Skirting runs

on three walls only: bed, left and right.

Every fitted piece to be built ⅝"–¾" undersize and scribed

on site to the wall it actually meets.

Furniture, partition and joinery are NOT shown.

Bathroom and dressing lie beyond the right wall — to come.

PROJECT	SHEET	SCALE	DATE	REV	DRAWING
A Study in Teak — The Room As Built	**Notes** Shell plan · measured on site	NTS	16.10.2026	7	**AST-DR-000 · 3 of 3**

ALL DIMENSIONS IN FEET & INCHES. PRINT ON A4 AT 100% / "ACTUAL SIZE" — NOT "FIT TO PAGE" — AND CHECK THE SCALE BAR. DO NOT SCALE; WORK TO FIGURED DIMENSIONS. VERIFY ON SITE.